LEGEND

- VACANT OFFICE SPACE
- VACANT STORAGE SPACE
- CURRENTLY LEASED SPACE

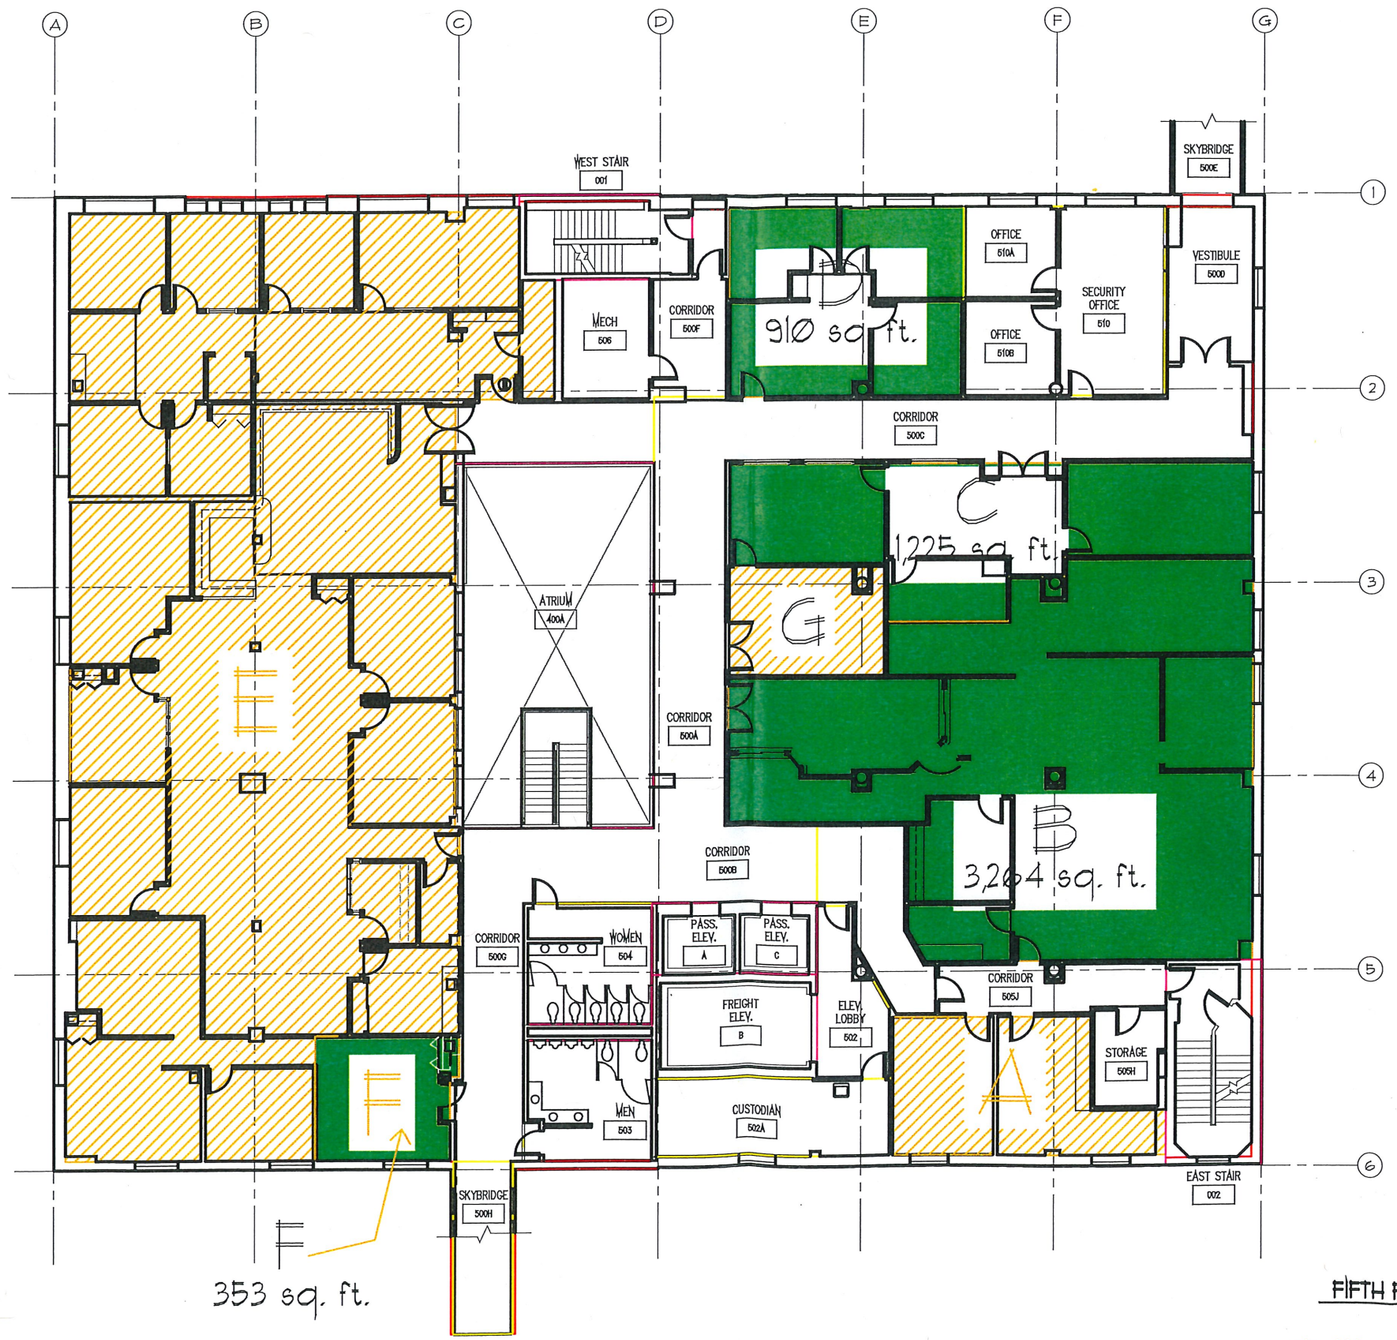

FIFTH FLOOR
NORTH

REVISED: March 30, 2010

AGENCY APPROVAL
DATE:

DRES ARCHITECT APPROVAL
DATE:

DRES LEASING APPROVAL
DATE:

DIVISION OF REAL ESTATE SERVICES
Design Manager
DATE:

BUILDING DATA

PROJECT #

SHEET NUMBER:

AS-BUILT FLOOR PLANS FOR
TACOMA CO-LOCATION
MARKET BUILDING
SOUTH 15th ST. & BROADWAY PLAZA
TACOMA, WA

ARCHITECT:
PRELIM. DATE:
FINAL DATE: 3-30-10
REVISIONS:
J.B.R. #
A.R. #
LEASE #

DEPARTMENT OF GENERAL ADMINISTRATION
DIVISION OF REAL ESTATE SERVICES
ARCHITECTURAL DESIGN SECTION
ADMINISTRATION BUILDING
230 GENERAL ADMINISTRATION BUILDING
P.O. BOX 41015 OLYMPIA, WA 98504-1016
(360) 902-7373

LEGEND

- VACANT OFFICE SPACE
- VACANT STORAGE SPACE
- CURRENTLY LEASED SPACE

SIXTH FLOOR
NORTH

REVISED: March 30, 2010

AGENCY APPROVAL

DATE:

DRES ARCHITECT APPROVAL

DATE:

DRES LEASING APPROVAL

DATE:

DIVISION OF REAL ESTATE SERVICES

Design Manager

DATE:

BUILDING DATA

AS-BUILT FLOOR PLANS FOR
TACOMA CO-LOCATION
MARKET BUILDING
SOUTH 14th ST. & BROADWAY PLAZA
TACOMA, WA

DEPARTMENT OF GENERAL ADMINISTRATION
DIVISION OF REAL ESTATE SERVICES
ARCHITECTURAL DESIGN SECTION
230 GENERAL ADMINISTRATION BUILDING
P.O. BOX 41015 OLYMPIA, WA 98504-1016
(360) 902-7373

REVISIONS:

ARCHITECT:	J.R. #
PRELIM. DATE:	A.R. #
FINAL DATE: 3-30-10	LEASE #

PROJECT #

SHEET NUMBER:

LEGEND

- VACANT OFFICE SPACE
- VACANT STORAGE SPACE
- CURRENTLY LEASED SPACE

SEVENTH FLOOR
NORTH

REVISED: March 30, 2010

AGENCY APPROVAL

DATE:

DRES ARCHITECT APPROVAL

DATE:

DRES LEASING APPROVAL

DATE:

DIVISION OF REAL ESTATE SERVICES

Design Manager

DATE:

BUILDING DATA

PROJECT #

SHEET NUMBER:

AS-BUILT FLOOR PLANS FOR
TACOMA CO-LOCATION
MARKET BUILDING
SOUTH 15th ST. & BROADWAY PLAZA
TACOMA, WA

DEPARTMENT OF GENERAL ADMINISTRATION
DIVISION OF REAL ESTATE SERVICES
ARCHITECTURAL DESIGN SECTION
230 GENERAL ADMINISTRATION BUILDING
P.O. BOX 41015 OLYMPIA, WA 98504-1015
(360) 902-7373

ARCHITECT: | J.I.R. #
PRELIM. DATE: | A.I.R. #
FINAL DATE: 3-8-9 | LEASE #

REVISIONS:

LEGEND

- VACANT OFFICE SPACE
- VACANT STORAGE SPACE
- CURRENTLY LEASED SPACE

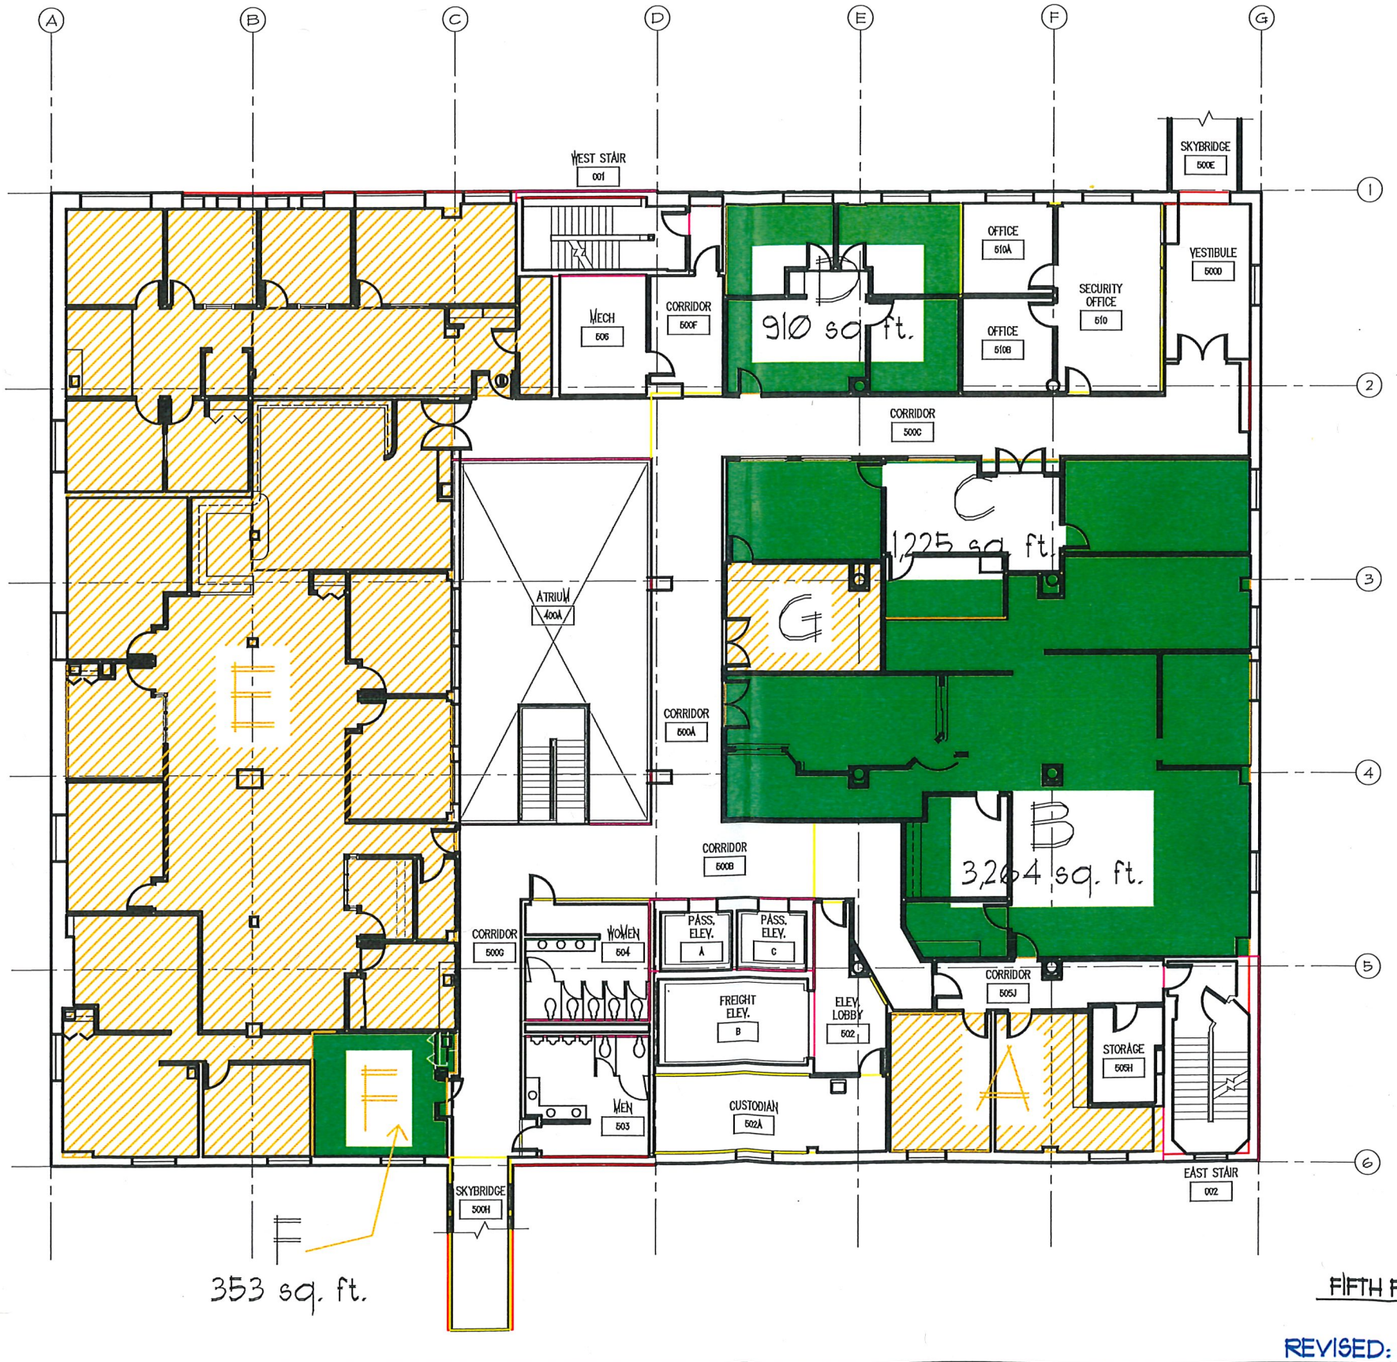

FIFTH FLOOR

NORTH

REVISED: March 30, 2010

AGENCY APPROVAL

DATE:

DRES ARCHITECT APPROVAL

DATE:

DRES LEASING APPROVAL

DATE:

DIVISION OF REAL ESTATE SERVICES

Design Manager

DATE:

BUILDING DATA

PROJECT #

SHEET NUMBER:

AS-BUILT FLOOR PLANS FOR:

TACOMA CO-LOCATION MARKET BUILDING

SOUTH 14th ST. & BROADWAY PLAZA

TACOMA, WA

DEPARTMENT OF GENERAL ADMINISTRATION
DIVISION OF REAL ESTATE SERVICES
ARCHITECTURAL DESIGN SECTION
ADMINISTRATION BUILDING
P.O. BOX 41016 OLYMPIA, WA 98504-1016
(360) 902-7573

ARCHITECT:	F.E. #
PRELIM. DATE:	A.E. #
FINAL DATE: 3-8-9	LEASE #

REVISIONS:

LEGEND

- VACANT OFFICE SPACE
- VACANT STORAGE SPACE
- CURRENTLY LEASED SPACE

SIXTH FLOOR
NORTH

REVISED: March 30, 2010

AGENCY APPROVAL

DATE:

DRES ARCHITECT APPROVAL

DATE:

DRES LEASING APPROVAL

DATE:

DIVISION OF REAL ESTATE SERVICES

Design Manager

DATE:

BUILDING DATA

PROJECT #

SHEET NUMBER:

AS-BUILT FLOOR PLANS FOR
TACOMA CO-LOCATION
MARKET BUILDING
TACOMA, WA

DEPARTMENT OF GENERAL ADMINISTRATION
DIVISION OF REAL ESTATE SERVICES
ARCHITECTURAL DESIGN SECTION
230 GENERAL ADMINISTRATION BUILDING
P.O. BOX 41015 OLYMPIA, WA 98504-1015
(360) 902-7373

REVISIONS:

ARCHITECT:	P.E. #
PRELIM. DATE:	A.R. #
FINAL DATE: 3-6-09	LEASE #

LEGEND

- VACANT OFFICE SPACE
- VACANT STORAGE SPACE
- CURRENTLY LEASED SPACE

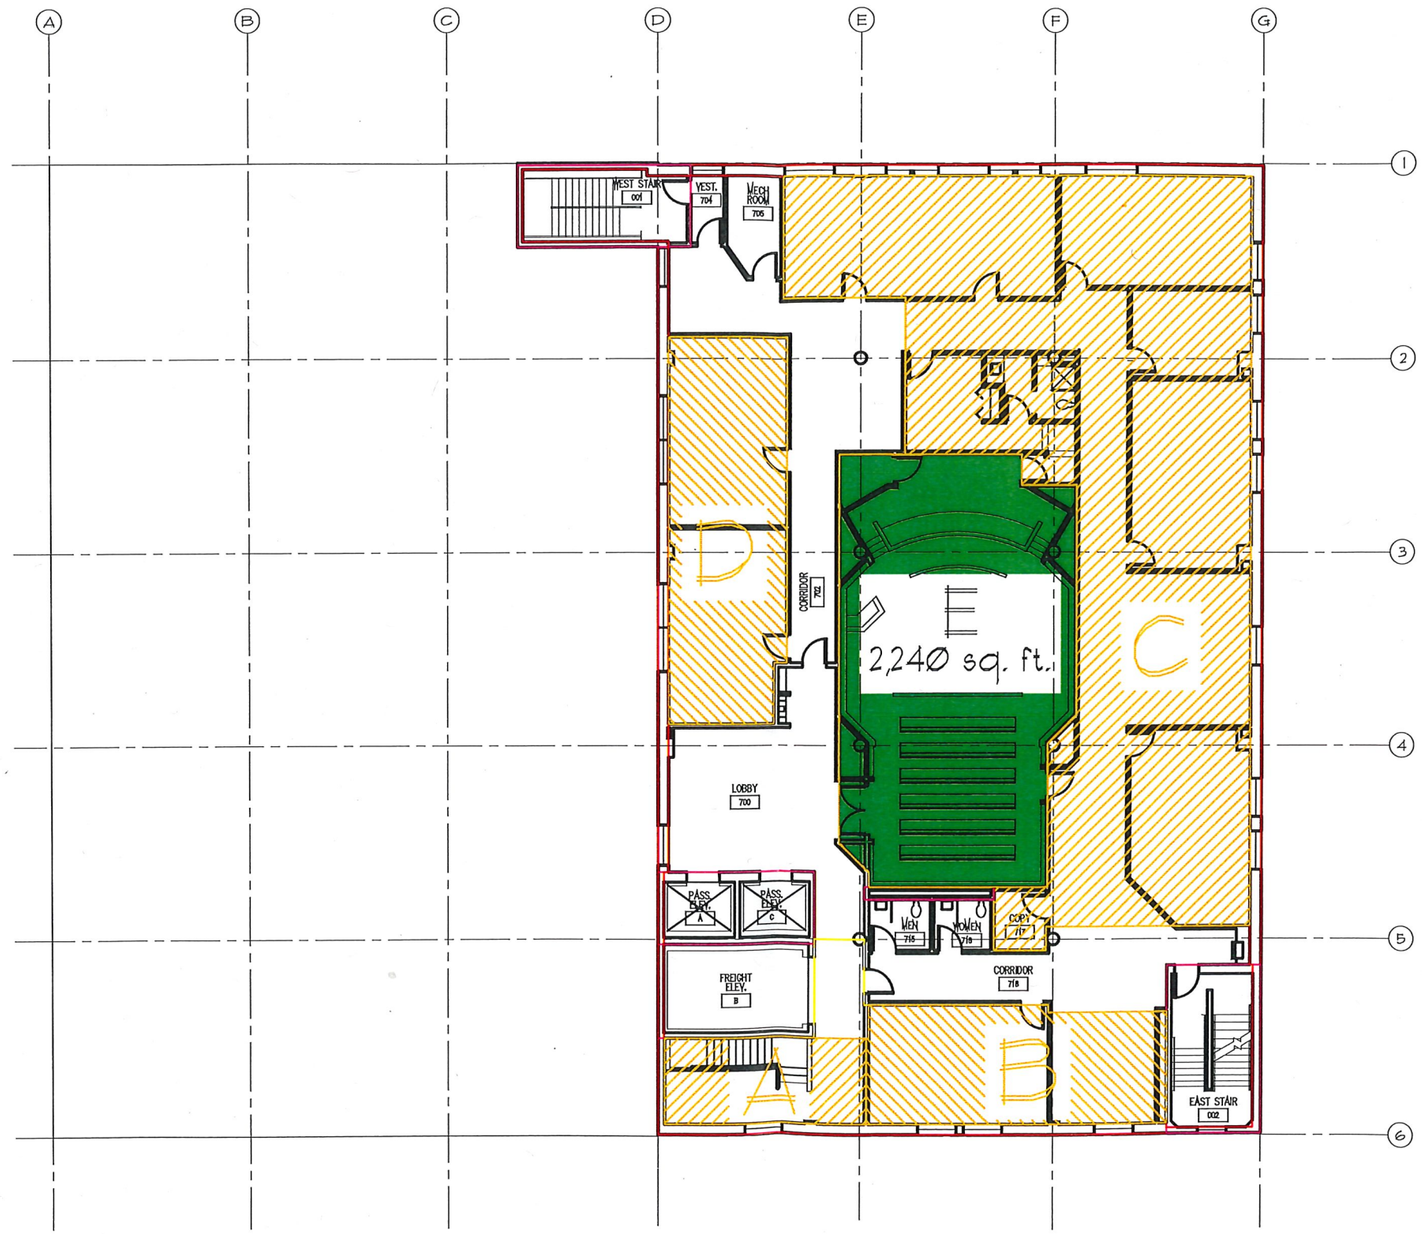

SEVENTH FLOOR
NORTH

REVISED: March 30, 2010

AGENCY APPROVAL

DATE:

DRES ARCHITECT APPROVAL

DATE:

DRES LEASING APPROVAL

DATE:

DIVISION OF REAL ESTATE SERVICES

Design Manager

DATE:

BUILDING DATA

AS-BUILT FLOOR PLANS FOR:

TACOMA CO-LOCATION MARKET BUILDING

SOUTH 15th ST. & BROADWAY PLAZA

TACOMA, WA

DEPARTMENT OF GENERAL ADMINISTRATION
DIVISION OF REAL ESTATE SERVICES
ARCHITECTURAL DESIGN SECTION
230 GENERAL ADMINISTRATION BUILDING
P.O. BOX 41015 OLYMPIA, WA 98504-1015
(360) 902-7373

ARCHITECT:

PRELIM. DATE:

FINAL DATE: 3-6-09

REVISIONS:

S.E. #

A.E. #

LEASE #

PROJECT #

SHEET NUMBER:

LEGEND

- VACANT OFFICE SPACE
- VACANT STORAGE SPACE
- CURRENTLY LEASED SPACE

FIRST FLOOR
NORTH

REVISED: March 30, 2010

AGENCY APPROVAL

DATE:

DRES ARCHITECT APPROVAL

DATE:

DRES LEASING APPROVAL

DATE:

DIVISION OF REAL ESTATE SERVICES

Design Manager

DATE:

BUILDING DATA

DEPARTMENT OF GENERAL ADMINISTRATION
DIVISION OF REAL ESTATE SERVICES
ARCHITECTURAL DESIGN SECTION
230 GENERAL ADMINISTRATION BUILDING
P.O. BOX 41015 OLYMPIA, WA 98504-1015
(360) 902-7373

REVISIONS:

ARCHITECT:	F.R. #
PRELIM. DATE:	A.E. #
FINAL DATE: 3-5-10	LEASE #

AS-BUILT FLOOR PLANS FOR
TACOMA CO-LOCATION
MARKET BUILDING
SOUTH 1ST & BROADWAY PLAZA
TACOMA, WA

PROJECT #

SHEET NUMBER:

LEGEND

- VACANT OFFICE SPACE
- VACANT STORAGE SPACE
- CURRENTLY LEASED SPACE

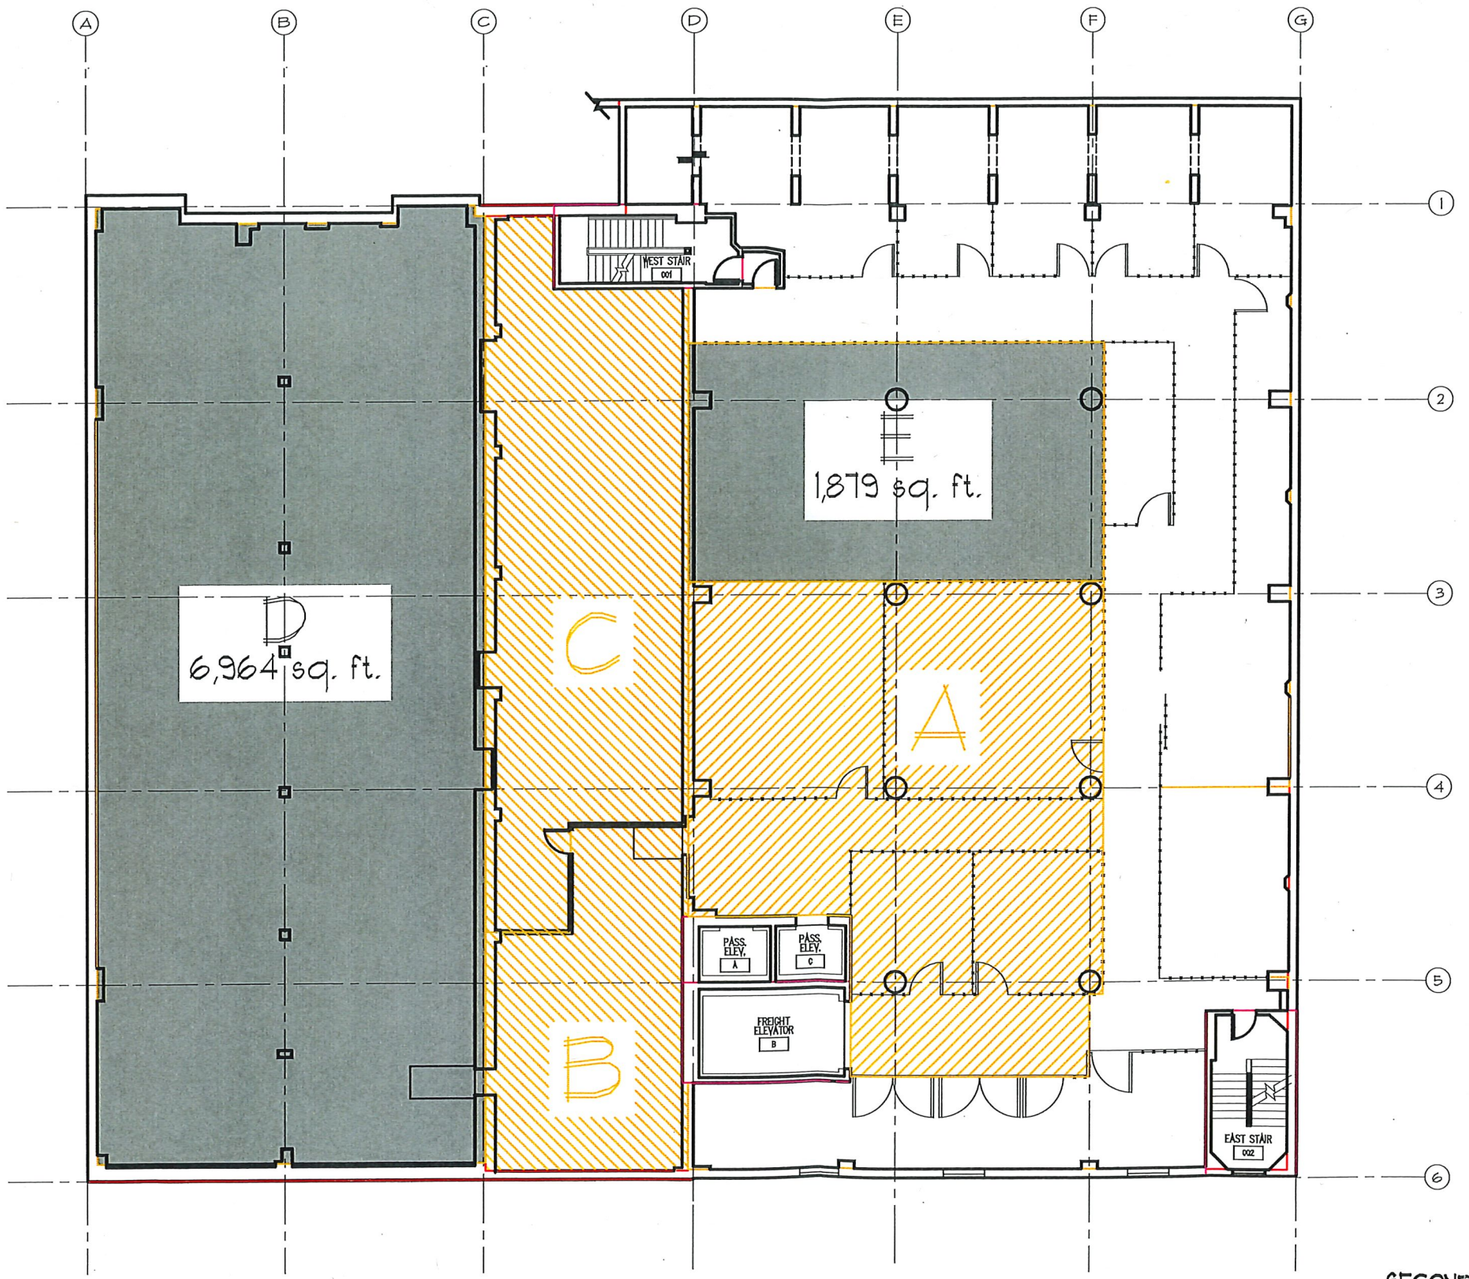

SECOND FLOOR
NORTH

REVISED: March 30, 2010

AGENCY APPROVAL

DATE:

DRES ARCHITECT APPROVAL

DATE:

DRES LEASING APPROVAL

DATE:

DIVISION OF REAL ESTATE SERVICES

Design Manager

DATE:

BUILDING DATA

AS-BUILT FLOOR PLANS FOR
TACOMA CO-LOCATION
MARKET BUILDING
SOUTH 16th ST. & BROADWAY PLAZA
TACOMA, WA

PROJECT #

SHEET NUMBER:

DEPARTMENT OF GENERAL ADMINISTRATION
DIVISION OF REAL ESTATE SERVICES
ARCHITECTURAL DESIGN SECTION
230 GENERAL ADMINISTRATION BUILDING
P.O. BOX 41015 OLYMPIA, WA 98504-1016
(360) 902-7373

ARCHITECT:

PRELIM. DATE:

FINAL DATE: 3-30-10

J.R. #

A.R. #

LEASE #

REVISIONS:

LEGEND

- VACANT OFFICE SPACE
- VACANT STORAGE SPACE
- CURRENTLY LEASED SPACE

THIRD FLOOR
NORTH

REVISED: March 30, 2010

DEPARTMENT OF GENERAL ADMINISTRATION
DIVISION OF REAL ESTATE SERVICES
ARCHITECTURAL DESIGN SECTION
230 GENERAL ADMINISTRATION BUILDING
P.O. BOX 41015 OLYMPIA, WA 98504-1015
(360) 902-7373

REVISIONS:

ARCHITECT:	G.R. #
PRELIM. DATE:	A.R. #
FINAL DATE: 3-30-10	LEASE #

AS-BUILT FLOOR PLANS FOR
TACOMA CO-LOCATION
MARKET BUILDING
TACOMA, WA.

AGENCY APPROVAL
DATE:
DRES ARCHITECT APPROVAL
DATE:
DRES LEASING APPROVAL
DATE:
DIVISION OF REAL ESTATE SERVICES
Design Manager
DATE:
BUILDING DATA

PROJECT #
SHEET NUMBER:

LEGEND

- VACANT OFFICE SPACE
- VACANT STORAGE SPACE
- CURRENTLY LEASED SPACE

FOURTH FLOOR
NORTH

REVISED: March 30, 2010

AGENCY APPROVAL

DATE:

DRES ARCHITECT APPROVAL

DATE:

DRES LEASING APPROVAL

DATE:

DIVISION OF REAL ESTATE SERVICES

Design Manager

DATE:

BUILDING DATA

DEPARTMENT OF GENERAL ADMINISTRATION
DIVISION OF REAL ESTATE SERVICES
ARCHITECTURAL DESIGN SECTION
230 GENERAL ADMINISTRATION BUILDING
P.O. BOX 41015 OLYMPIA, WA 98504-1015
(360) 902-7373

AS-BUILT FLOOR PLANS FOR
TACOMA CO-LOCATION
MARKET BUILDING
TACOMA, WA

ARCHITECT:
PRELIM. DATE:
FINAL DATE: 3-10-10

G.R. #
A.R. #
LEASE #

REVISIONS:

PROJECT #

SHEET NUMBERS:

LEGEND

- VACANT OFFICE SPACE
- VACANT STORAGE SPACE
- CURRENTLY LEASED SPACE

FIRST FLOOR
NORTH

REVISED: March 30, 2010

AGENCY APPROVAL
DATE:

DRES ARCHITECT APPROVAL
DATE:

DRES LEASING APPROVAL
DATE:

DIVISION OF REAL ESTATE SERVICES
Design Manager
DATE:

BUILDING DATA

PROJECT #

SHEET NUMBER:

AS-BUILT FLOOR PLANS FOR
TACOMA CO-LOCATION
MARKET BUILDING
SOUTH 15th ST. & BROADWAY PLAZA
TACOMA, WA

ARCHITECT:
PRELIM. DATE:
FINAL DATE: 3-30-10

REVISIONS:

S.R. #
A.R. #
LEASE #

DEPARTMENT OF GENERAL ADMINISTRATION
DIVISION OF REAL ESTATE SERVICES
ARCHITECTURAL DESIGN SECTION
230 GENERAL ADMINISTRATION BUILDING
P.O. BOX 41015 OLYMPIA, WA 98504-1015
(360) 902-7373

LEGEND

- VACANT OFFICE SPACE
- VACANT STORAGE SPACE
- CURRENTLY LEASED SPACE

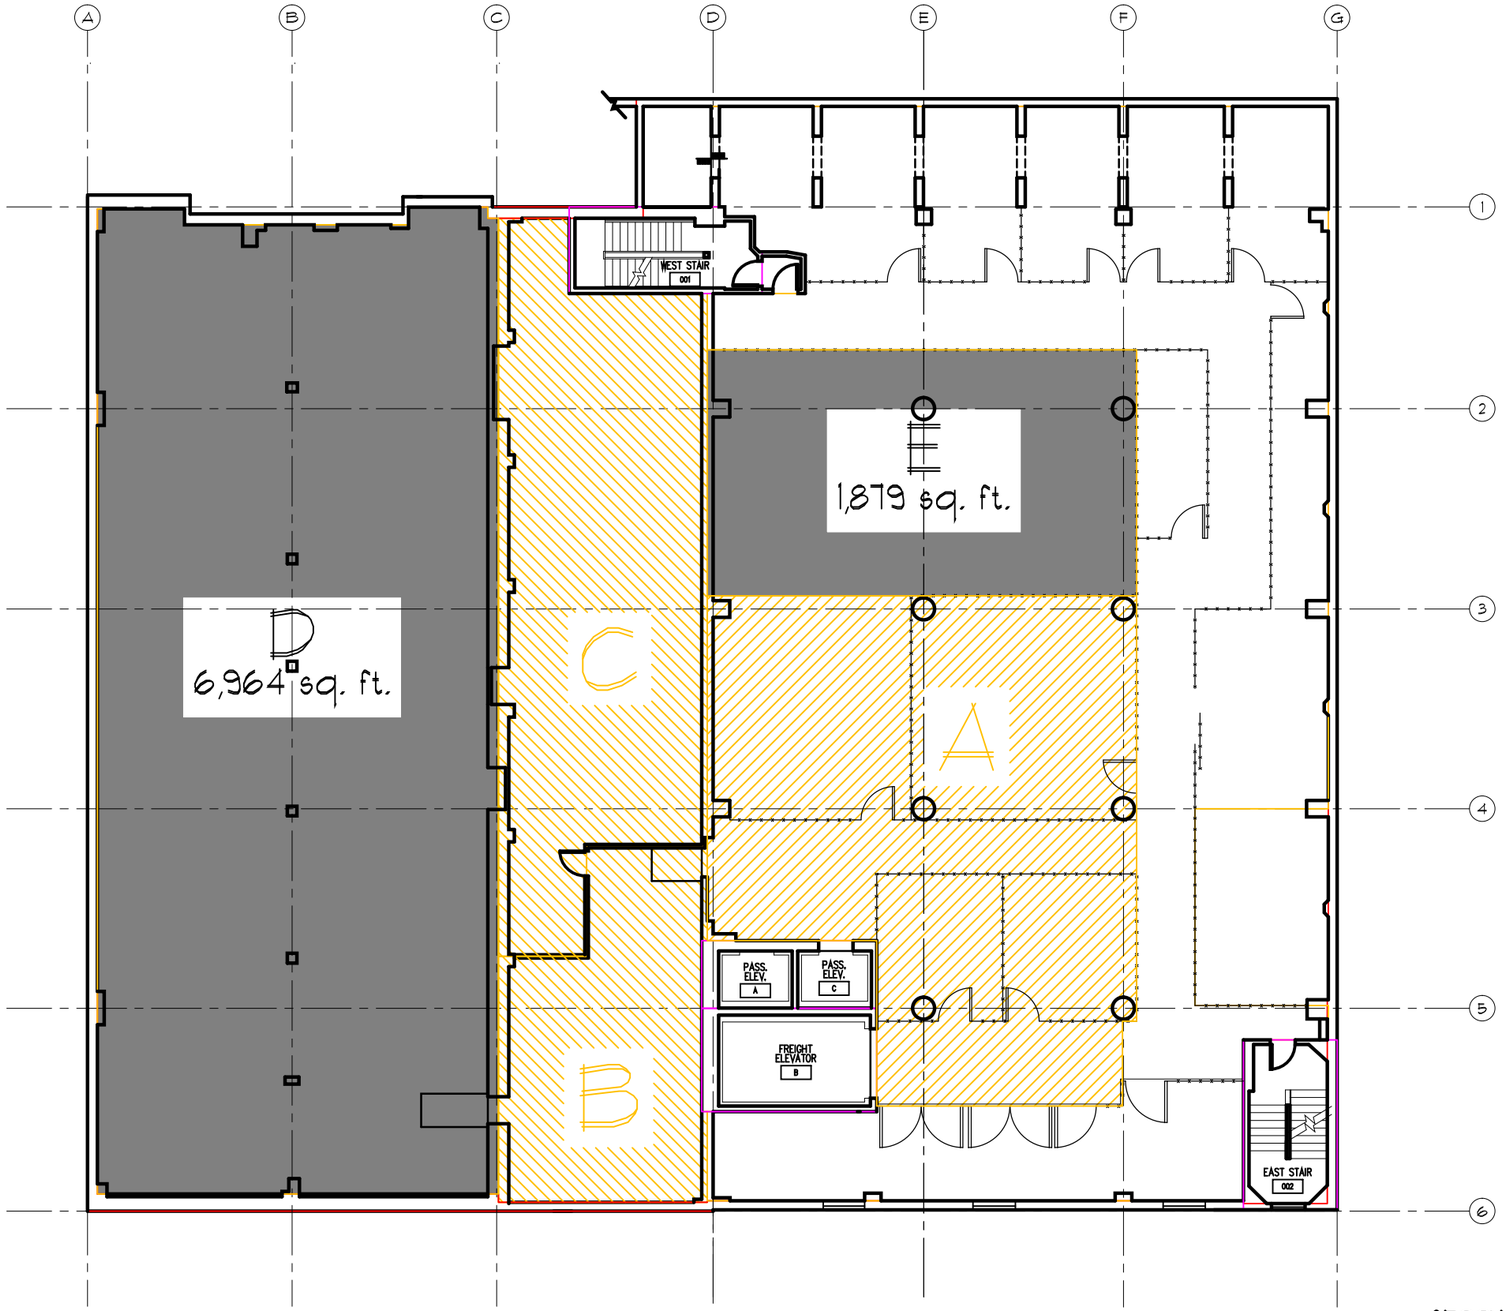

SECOND FLOOR
NORTH

REVISED: March 30, 2010

AGENCY APPROVAL

DATE:

DRES ARCHITECT APPROVAL

DATE:

DRES LEASING APPROVAL

DATE:

DIVISION OF REAL ESTATE SERVICES

Design Manager

DATE:

BUILDING DATA

PROJECT #

SHEET NUMBER:

DEPARTMENT OF GENERAL ADMINISTRATION
DIVISION OF REAL ESTATE SERVICES
ARCHITECTURAL DESIGN SECTION
230 GENERAL ADMINISTRATION BUILDING
P.O. BOX 41015 OLYMPIA, WA 98504-1015
(360) 902-7373

ARCHITECT:

REVISIONS:

S.R. #

A.R. #

LEASE #

PRELIM. DATE:

FINAL DATE: 3-30-10

AS-BUILT FLOOR PLANS FOR
TACOMA CO-LOCATION
MARKET BUILDING
TACOMA, WA

LEGEND

- VACANT OFFICE SPACE
- VACANT STORAGE SPACE
- CURRENTLY LEASED SPACE

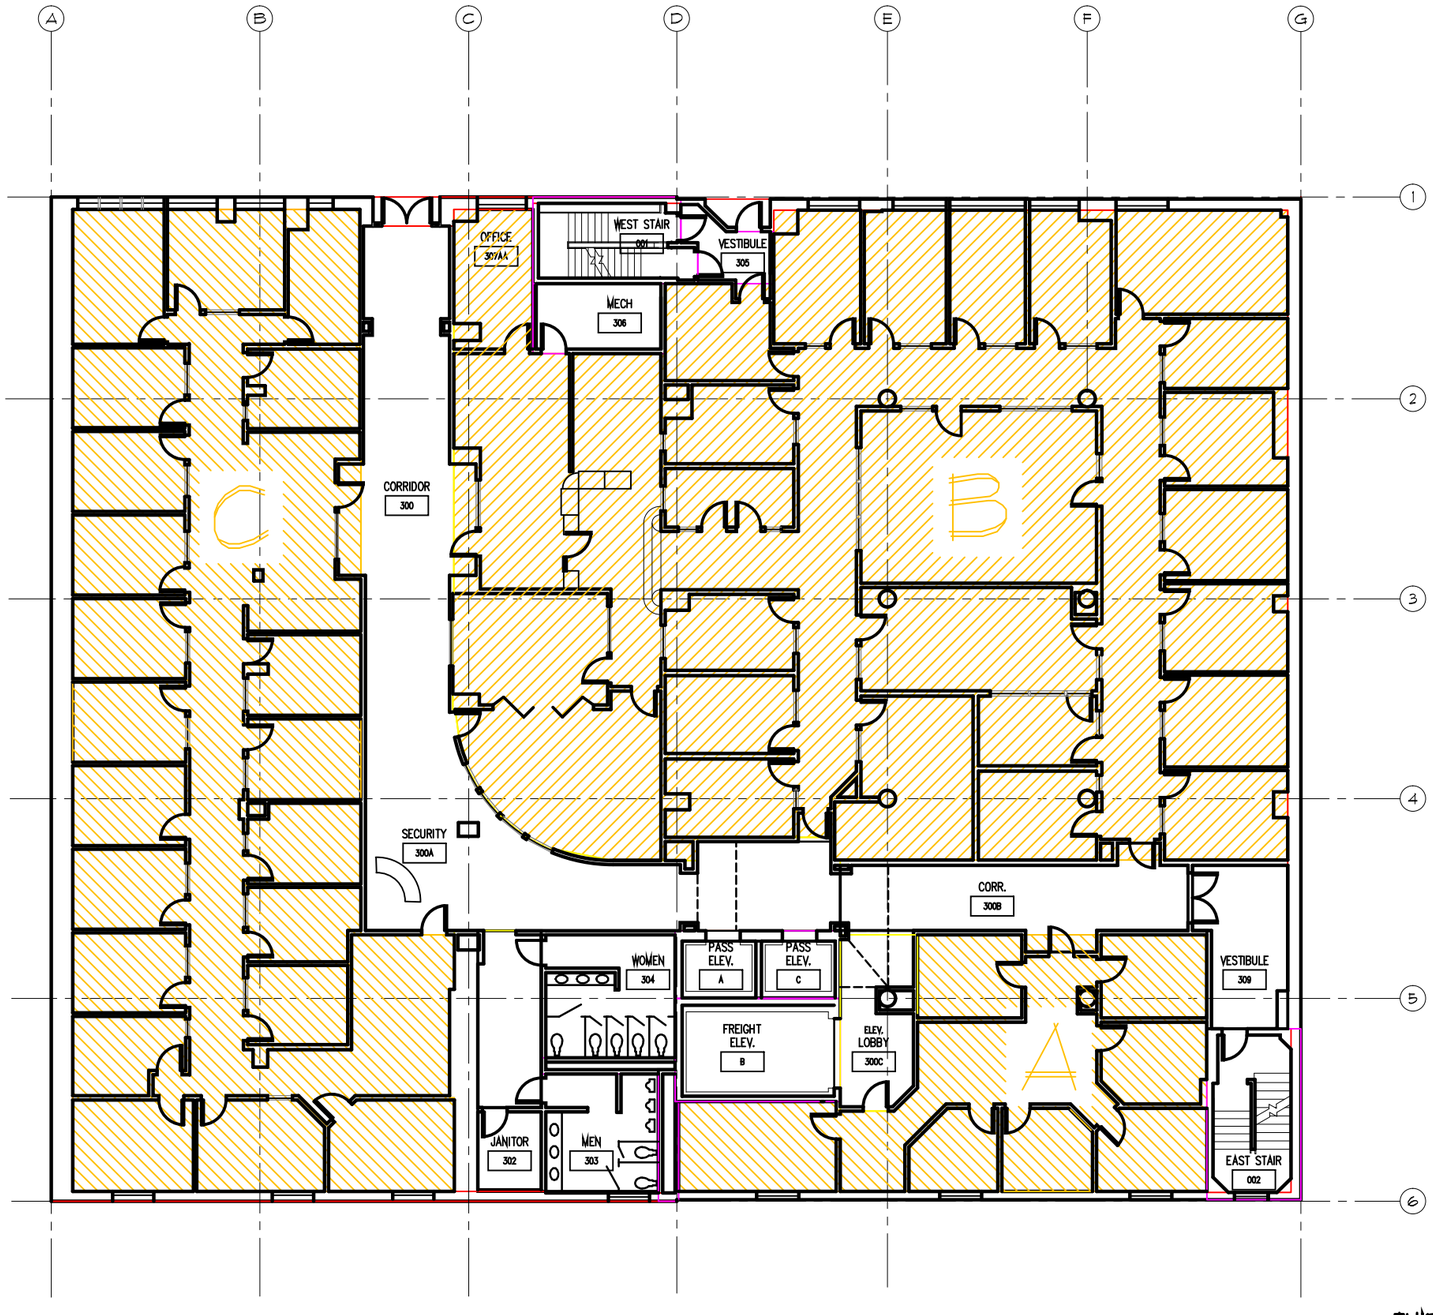

THIRD FLOOR
NORTH

REVISED: March 30, 2010

AGENCY APPROVAL

DATE:

DRES ARCHITECT APPROVAL

DATE:

DRES LEASING APPROVAL

DATE:

DIVISION OF REAL ESTATE SERVICES

Design Manager

DATE:

BUILDING DATA

PROJECT #

SHEET NUMBER:

REVISIONS:

S.R. #	A.R. #	LEASE #
PRELIM. DATE:	FINAL DATE: 3-30-10	

ARCHITECT:

DEPARTMENT OF GENERAL ADMINISTRATION
DIVISION OF REAL ESTATE SERVICES
ARCHITECTURAL DESIGN SECTION
230 GENERAL ADMINISTRATION BUILDING
P.O. BOX 41015 OLYMPIA, WA 98504-1015
(360) 902-7373

AS-BUILT FLOOR PLANS FOR

TACOMA CO-LOCATION MARKET BUILDING

SOUTH 15th ST. & BROADWAY PLAZA

TACOMA WA

LEGEND

- VACANT OFFICE SPACE
- VACANT STORAGE SPACE
- CURRENTLY LEASED SPACE

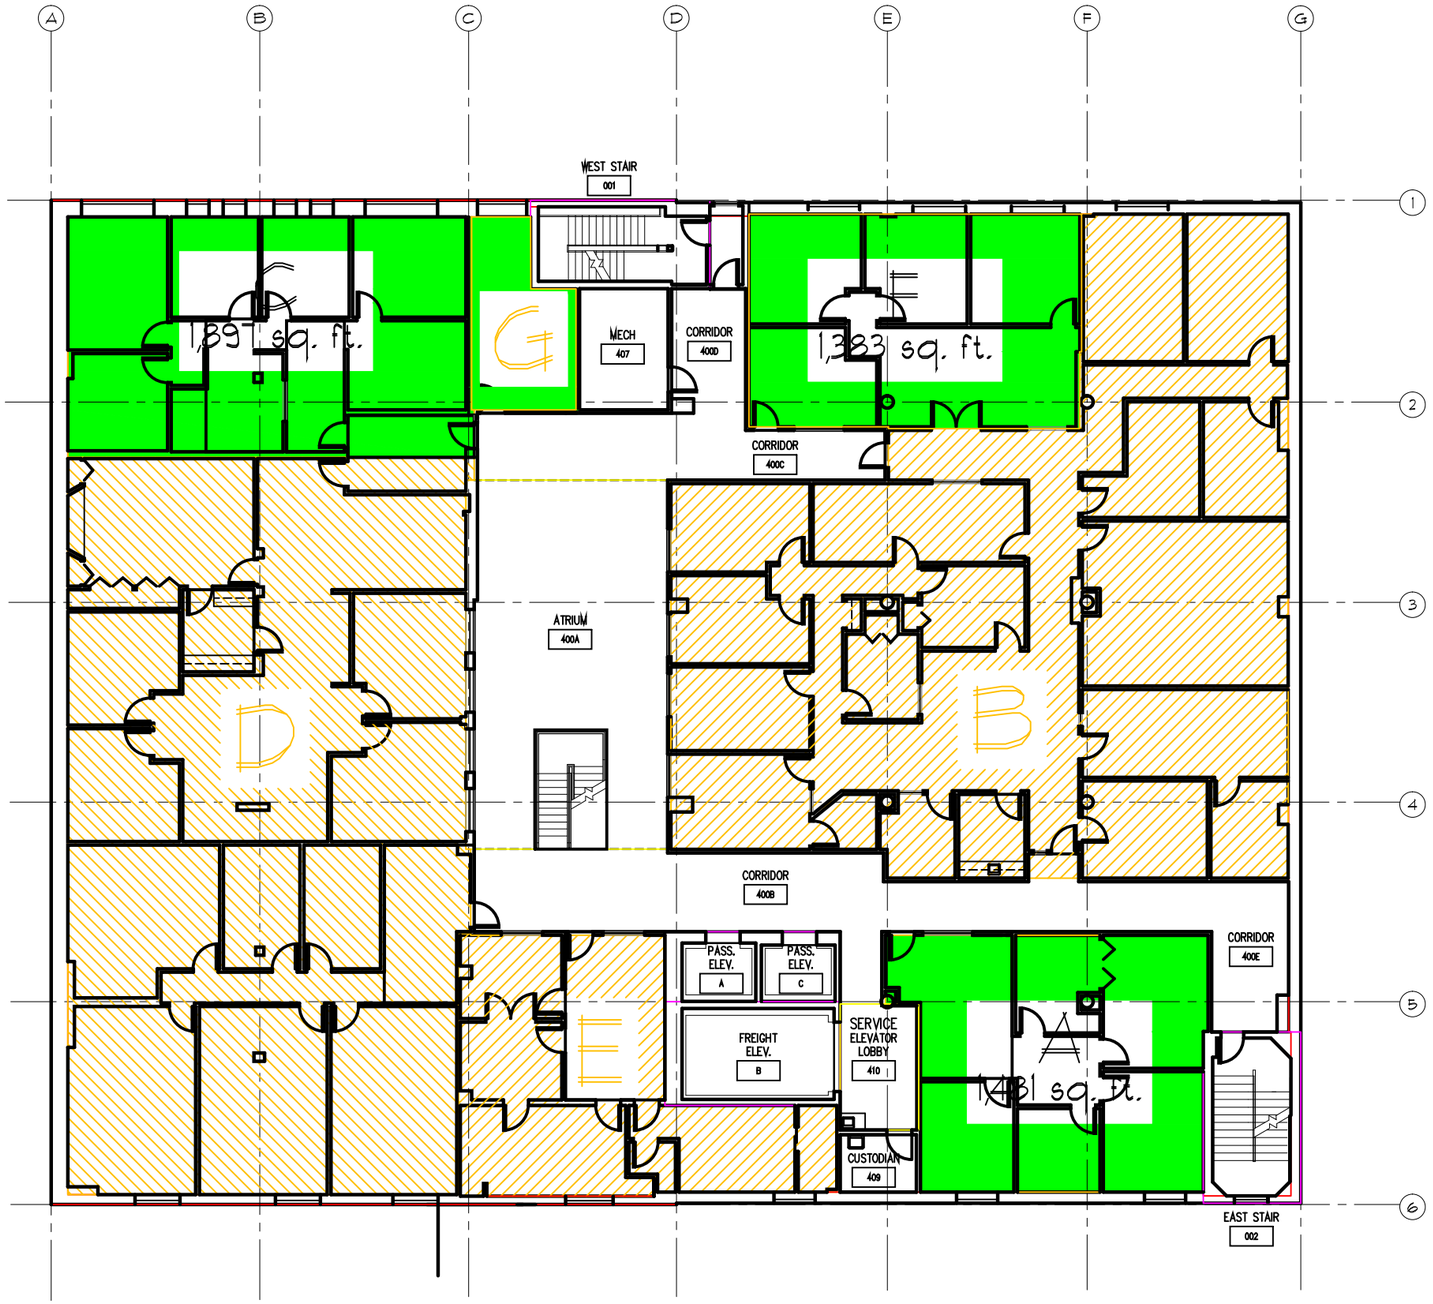

FOURTH FLOOR
NORTH

REVISED: March 30, 2010

AGENCY APPROVAL

DATE:

DRES ARCHITECT APPROVAL

DATE:

DRES LEASING APPROVAL

DATE:

DIVISION OF REAL ESTATE SERVICES

Design Manager

DATE:

BUILDING DATA

DEPARTMENT OF GENERAL ADMINISTRATION
DIVISION OF REAL ESTATE SERVICES
ARCHITECTURAL DESIGN SECTION
230 GENERAL ADMINISTRATION BUILDING
P.O. BOX 41015 OLYMPIA, WA 98504-1015
(360) 902-7373

ARCHITECT:
S.R. #
A.R. #
LEASE #
PRELIM. DATE:
FINAL DATE: 3-30-10
REVISIONS:

AS-BUILT FLOOR PLANS FOR
TACOMA CO-LOCATION MARKET BUILDING
SOUTH 15th ST. & BROADWAY PLAZA
TACOMA WA

PROJECT #

SHEET NUMBER:

LEGEND

- VACANT OFFICE SPACE
- VACANT STORAGE SPACE
- CURRENTLY LEASED SPACE

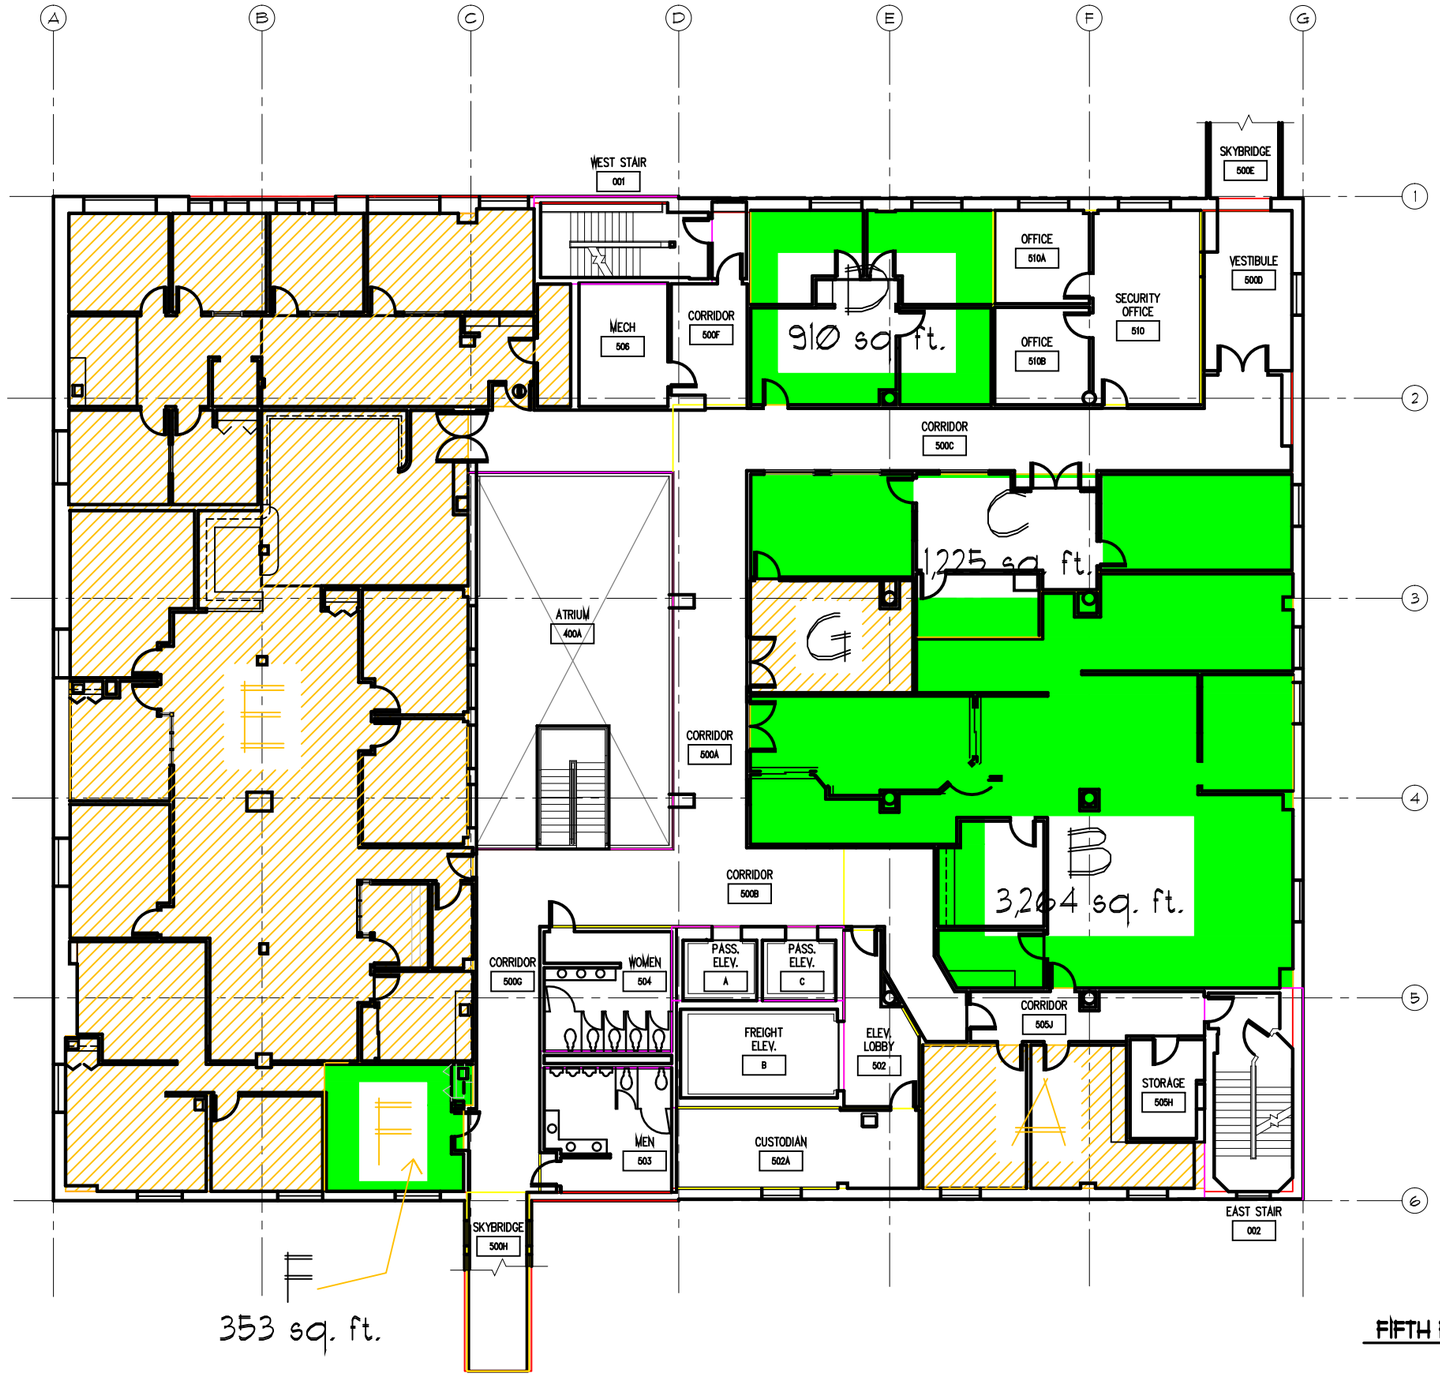

FIFTH FLOOR
NORTH

REVISED: March 30, 2010

AGENCY APPROVAL

DATE:

DRES ARCHITECT APPROVAL

DATE:

DRES LEASING APPROVAL

DATE:

DIVISION OF REAL ESTATE SERVICES

Design Manager

DATE:

BUILDING DATA

PROJECT #

SHEET NUMBER:

AS-BUILT FLOOR PLANS FOR
TACOMA CO-LOCATION
MARKET BUILDING
TACOMA, WA

ARCHITECT:

REVISIONS:

S.R. #

A.R. #

LEASE #

PRELIM. DATE:

FINAL DATE: 3-30-10

DEPARTMENT OF GENERAL ADMINISTRATION
DIVISION OF REAL ESTATE SERVICES
ARCHITECTURAL DESIGN SECTION
230 GENERAL ADMINISTRATION BUILDING
P.O. BOX 41015 OLYMPIA, WA 98504-1015
(360) 902-7373

LEGEND

- VACANT OFFICE SPACE
- VACANT STORAGE SPACE
- CURRENTLY LEASED SPACE

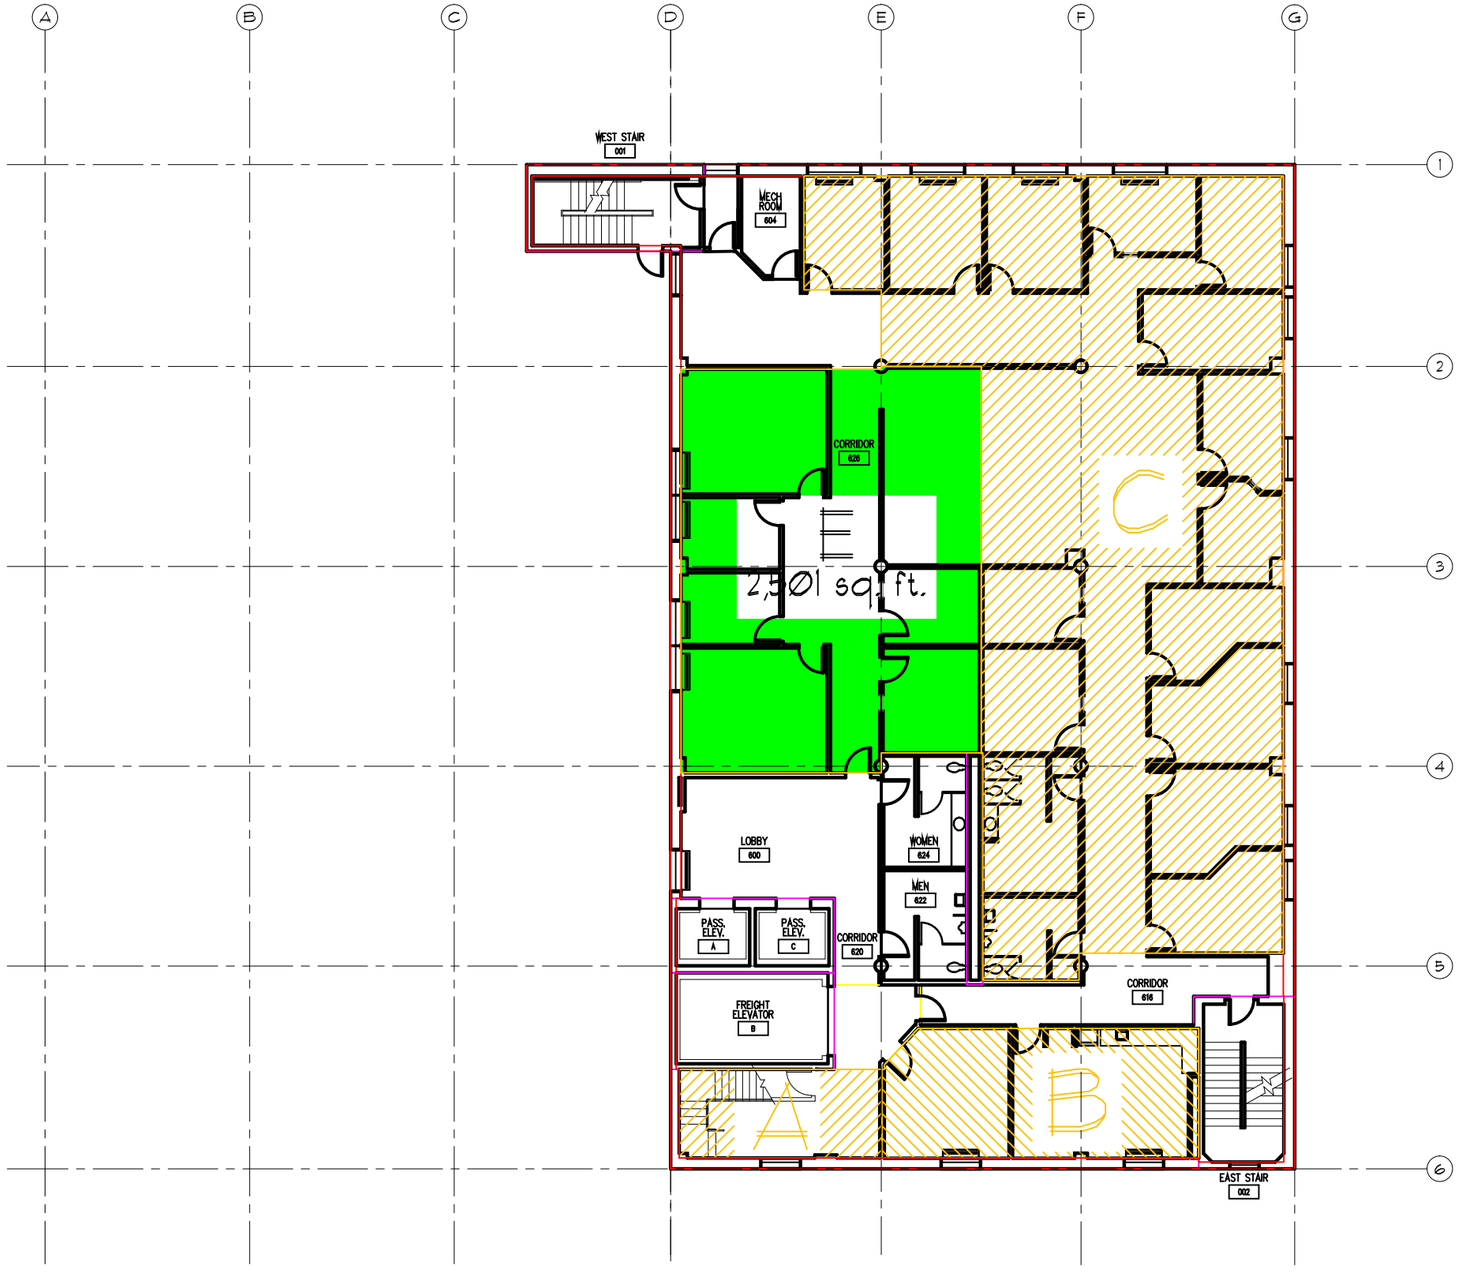

SIXTH FLOOR
NORTH

REVISED: March 30, 2010

DEPARTMENT OF GENERAL ADMINISTRATION
DIVISION OF REAL ESTATE SERVICES
ARCHITECTURAL DESIGN
230 GENERAL ADMINISTRATION BUILDING
P.O. BOX 41015 OLYMPIA, WA 98504-1015
(360) 902-7373

REVISIONS:

ARCHITECT:	S.R. #
PRELIM. DATE:	A.R. #
FINAL DATE: 3-30-10	LEASE #

AS-BUILT FLOOR PLANS FOR
TACOMA CO-LOCATION MARKET BUILDING
SOUTH 15th ST. & BROADWAY PLAZA
TACOMA, WA.

AGENCY APPROVAL
DATE:
DRES ARCHITECT APPROVAL
DATE:
DRES LEASING APPROVAL
DATE:
DIVISION OF REAL ESTATE SERVICES
Design Manager
DATE:
BUILDING DATA

PROJECT #

SHEET NUMBER:

LEGEND

- VACANT OFFICE SPACE
- VACANT STORAGE SPACE
- CURRENTLY LEASED SPACE

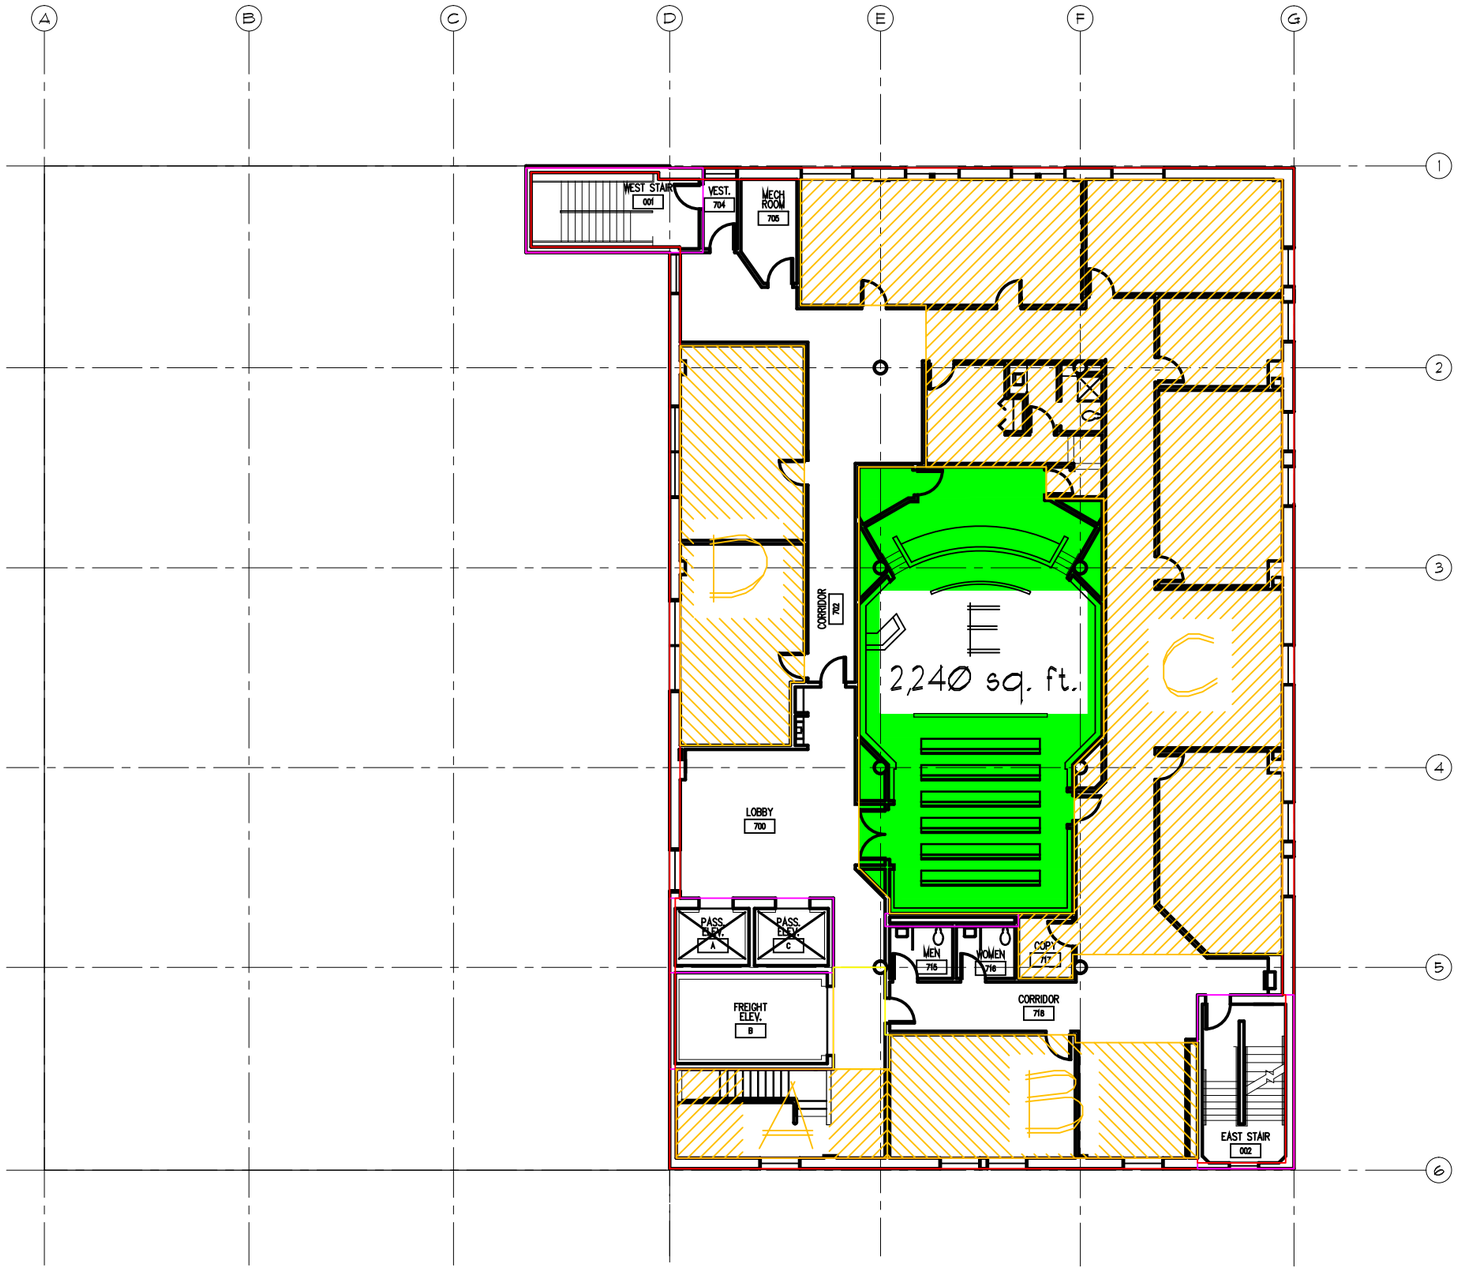

SEVENTH FLOOR
NORTH

REVISED: March 30, 2010

DEPARTMENT OF GENERAL ADMINISTRATION
DIVISION OF REAL ESTATE SERVICES
ARCHITECTURAL DESIGN SECTION
230 GENERAL ADMINISTRATION BUILDING
P.O. BOX 41015 OLYMPIA, WA 98504-1015
(360) 902-7373

REVISIONS:

ARCHITECT:	S.R. #
PRELIM. DATE:	A.R. #
FINAL DATE: 3-16-10	LEASE #

AS-BUILT FLOOR PLANS FOR
TACOMA CO-LOCATION
MARKET BUILDING
SOUTH 9th ST. & BROADWAY PLAZA
TACOMA, WA

AGENCY APPROVAL
DATE:
DRES ARCHITECT APPROVAL
DATE:
DRES LEASING APPROVAL
DATE:
DIVISION OF REAL ESTATE SERVICES
Design Manager
DATE:
BUILDING DATA

PROJECT #

SHEET NUMBER: