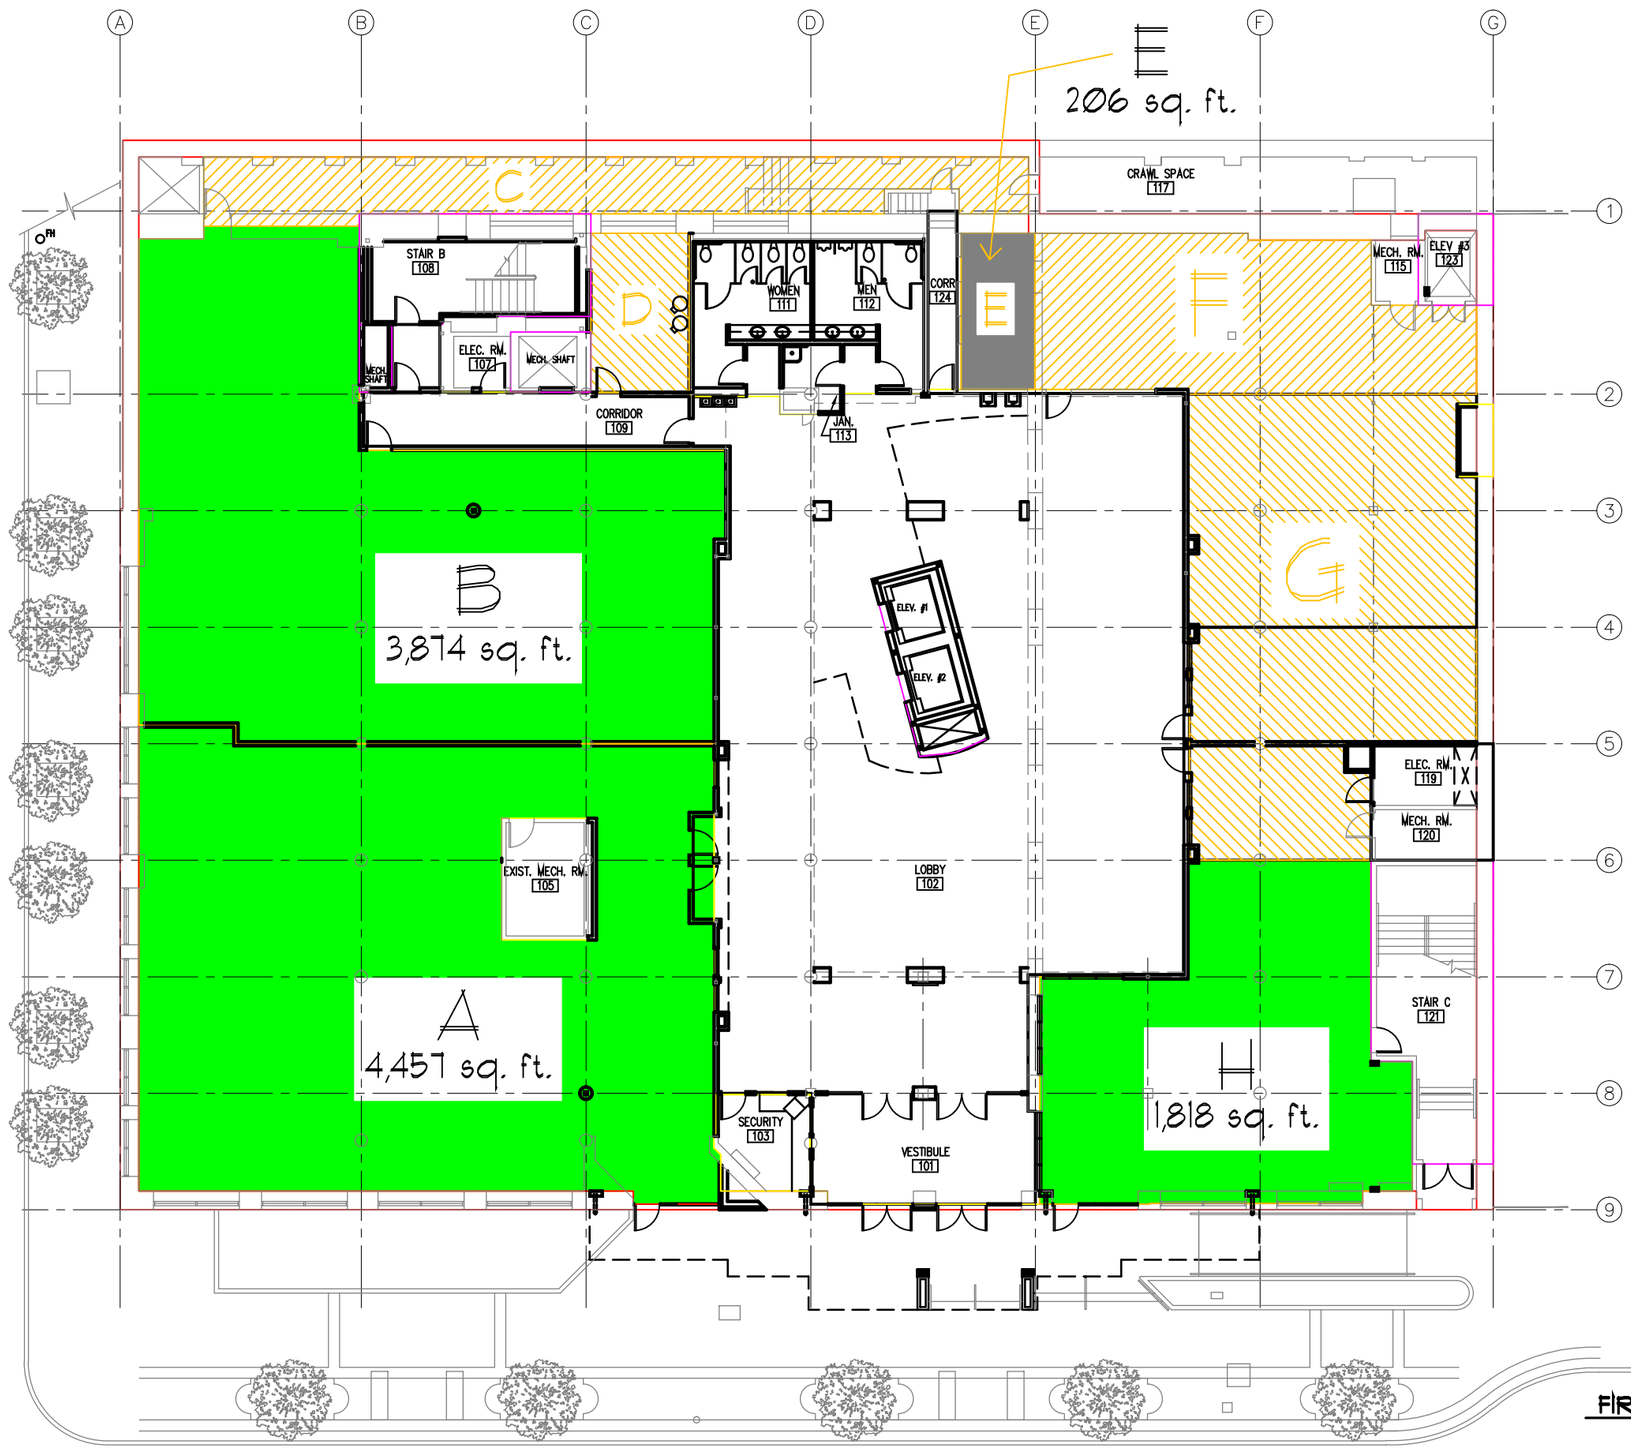

LEGEND

- VACANT OFFICE SPACE
- VACANT STORAGE SPACE
- CURRENTLY LEASED SPACE

FIRST FLOOR

NORTH

REVISED: March 30, 2010

AGENCY APPROVAL
DATE:
DRES ARCHITECT APPROVAL
DATE:
DRES LEASING APPROVAL
DATE:
DIVISION OF REAL ESTATE SERVICES
Design Manager
DATE:
BUILDING DATA

REVISIONS:

ARCHITECT: S.R. #

PRELIM. DATE: A.R. #

FINAL DATE: LEASE #

DEPARTMENT OF GENERAL ADMINISTRATION
DIVISION OF REAL ESTATE SERVICES
ARCHITECTURAL DESIGN SECTION
230 GENERAL ADMINISTRATION BUILDING
P.O. BOX 41015 OLYMPIA, WA 98504-1015
(360) 902-7373

AS-BUILT FLOOR PLANS FOR
TACOMA CO-LOCATION
BROADWAY BUILDING
COURT: 6th ST. & BROADWAY PLAZA
TACOMA, WA.

PROJECT #

SHEET NUMBER:

LEGEND

- VACANT OFFICE SPACE
- VACANT STORAGE SPACE
- CURRENTLY LEASED SPACE

SECOND FLOOR

NORTH

REVISED: March 30, 2010

AGENCY APPROVAL
DATE:
DRES ARCHITECT APPROVAL
DATE:
DRES LEASING APPROVAL
DATE:
DIVISION OF REAL ESTATE SERVICES
Design Manager
DATE:
BUILDING DATA

REVISIONS:

S.R. #

A.R. #

LEASE #

ARCHITECT:

PRELIM. DATE:

FINAL DATE: 3-30-10

DEPARTMENT OF GENERAL ADMINISTRATION
DIVISION OF REAL ESTATE SERVICES
ARCHITECTURAL DESIGN SECTION
230 GENERAL ADMINISTRATION BUILDING
OLYMPIA, WA 98504-1015
P.O. BOX 41015 (360) 902-7373

AS-BUILT FLOOR PLANS FOR
TACOMA CO-LOCATION
BROADWAY BUILDING
SOUTH 16th ST. & BROADWAY PLAZA
TACOMA, WA

PROJECT #

SHEET NUMBER:

LEGEND

- VACANT OFFICE SPACE
- VACANT STORAGE SPACE
- CURRENTLY LEASED SPACE

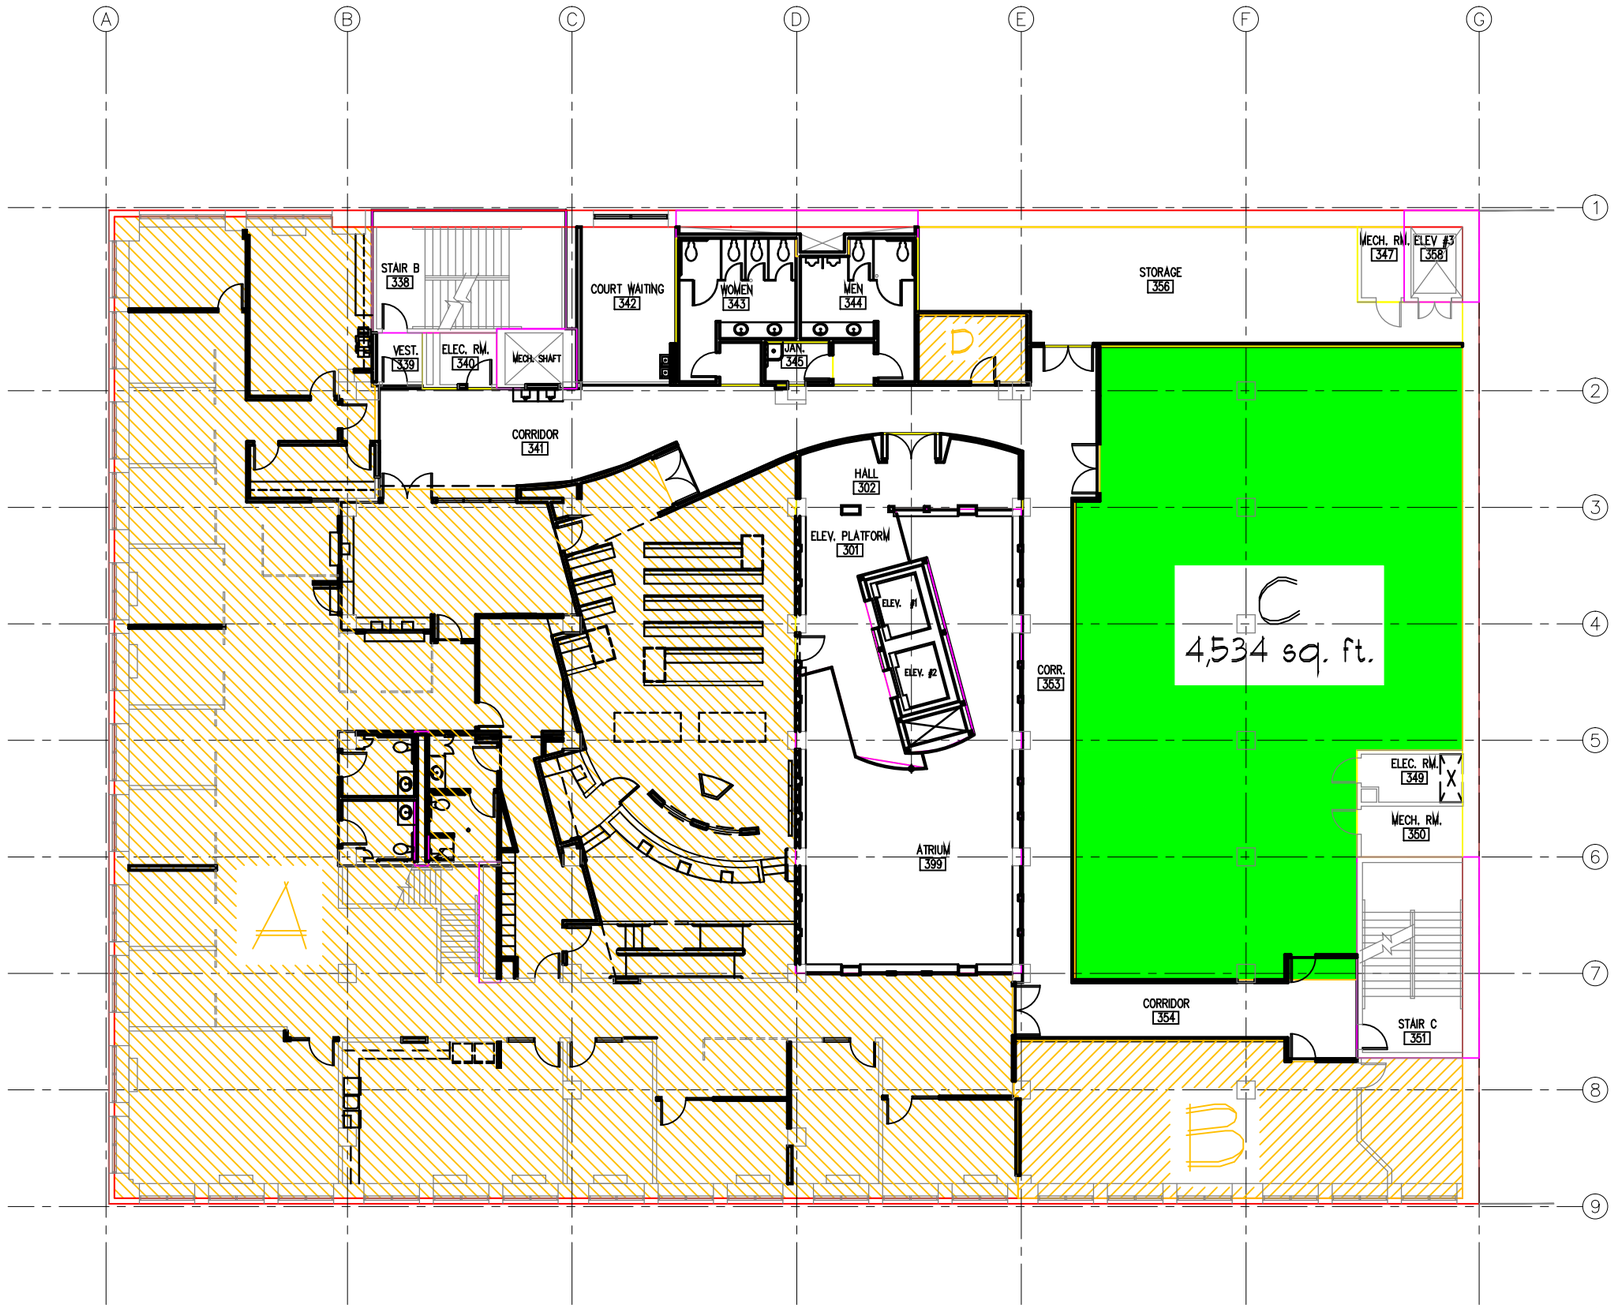

THIRD FLOOR
NORTH

REVISED: March 30, 2010

AGENCY APPROVAL
DATE:
DRES ARCHITECT APPROVAL
DATE:
DRES LEASING APPROVAL
DATE:
DIVISION OF REAL ESTATE SERVICES
Design Manager
DATE:
BUILDING DATA

REVISIONS:

ARCHITECT: S.R. #

PRELIM. DATE: A.R. #

FINAL DATE: LEASE #

DEPARTMENT OF GENERAL ADMINISTRATION
DIVISION OF REAL ESTATE SERVICES
ARCHITECTURAL DESIGN SECTION
230 GENERAL ADMINISTRATION BUILDING
P.O. BOX 41015 OLYMPIA, WA 98504-1015
(360) 902-7373

AS-BUILT FLOOR PLAN FOR
TACOMA CO-LOCATION BROADWAY BUILDING
SOUTH 11th ST. & BROADWAY PLAZA
TACOMA, WA

PROJECT #

SHEET NUMBER:

LEGEND

- VACANT OFFICE SPACE
- VACANT STORAGE SPACE
- CURRENTLY LEASED SPACE

FOURTH FLOOR
NORTH

REVISED: March 30, 2010

AGENCY APPROVAL
DATE:
DRES ARCHITECT APPROVAL
DATE:
DRES LEASING APPROVAL
DATE:
DIVISION OF REAL ESTATE SERVICES Design Manager
DATE:
BUILDING DATA

REVISIONS:

ARCHITECT: S.R. #
PRELIM. DATE: A.R. #
FINAL DATE: LEASE #

DEPARTMENT OF GENERAL ADMINISTRATION
DIVISION OF REAL ESTATE SERVICES
ARCHITECTURAL DESIGN SECTION
230 GENERAL ADMINISTRATION BUILDING
P.O. BOX 41015 OLYMPIA, WA 98504-1015
(360) 902-7373

AS-BUILT FLOOR PLANS FOR
TACOMA CO-LOCATION
BROADWAY BUILDING
SOUTH 16th ST. & BROADWAY PLAZA
TACOMA, WA

PROJECT #
SHEET NUMBER:

LEGEND

- VACANT OFFICE SPACE
- VACANT STORAGE SPACE
- CURRENTLY LEASED SPACE

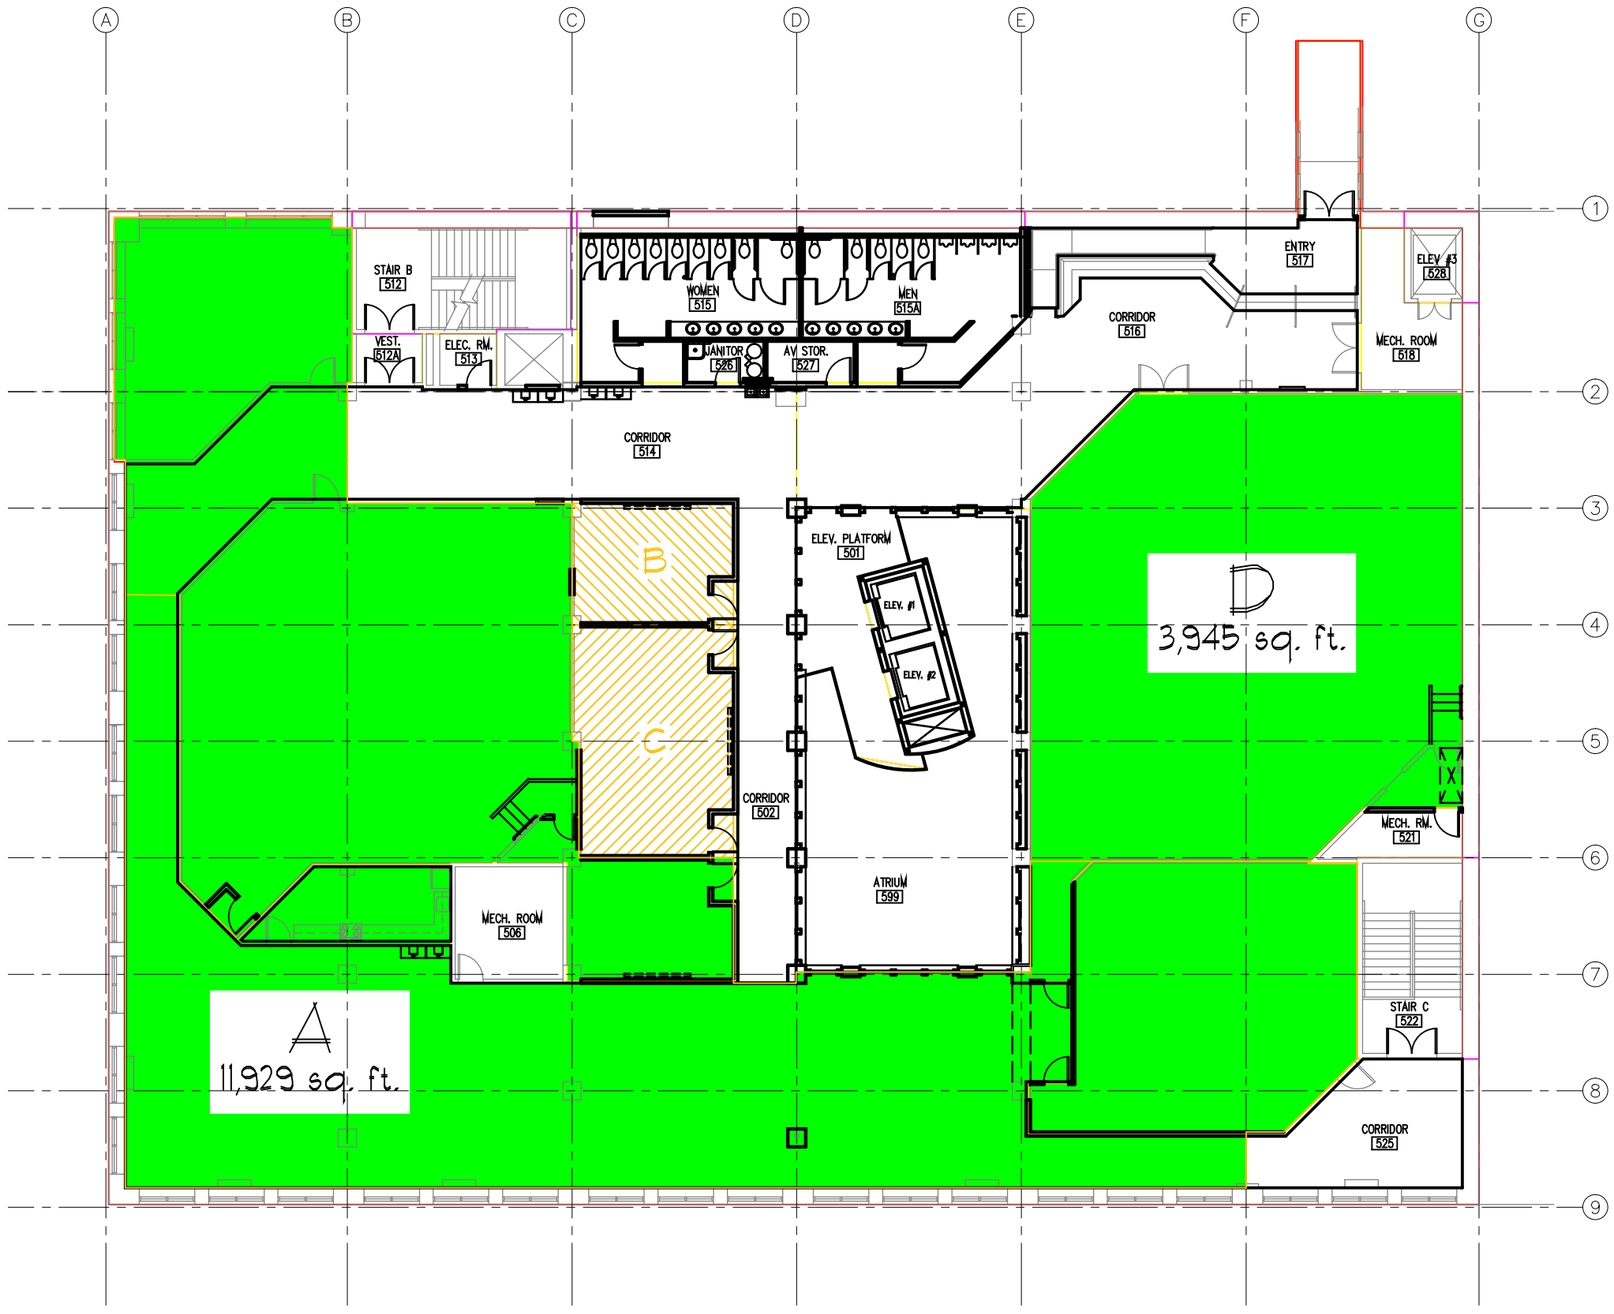

FIFTH FLOOR

NORTH

REVISED: March 30, 2010

AGENCY APPROVAL

DATE:

DRES ARCHITECT APPROVAL

DATE:

DRES LEASING APPROVAL

DATE:

DIVISION OF REAL ESTATE SERVICES

Design Manager

DATE:

BUILDING DATA

REVISIONS:

S.R. #

A.R. #

LEASE #

ARCHITECT:

PRELIM. DATE:

FINAL DATE: 3-30-10

DEPARTMENT OF GENERAL ADMINISTRATION
DIVISION OF REAL ESTATE SERVICES
ARCHITECTURAL DESIGN SECTION
230 GENERAL ADMINISTRATION BUILDING
P.O. BOX 41015 OLYMPIA, WA 98504-1015
(360) 902-7373

AS-BUILT FLOOR PLANS FOR

TACOMA CO-LOCATION
BROADWAY BUILDING

TACOMA, WA

SOUTH 11th ST. & BROADWAY PLAZA

PROJECT #

SHEET NUMBER: